





XX New room number as provided by DC Courts  
XX Unchanged Existing room number



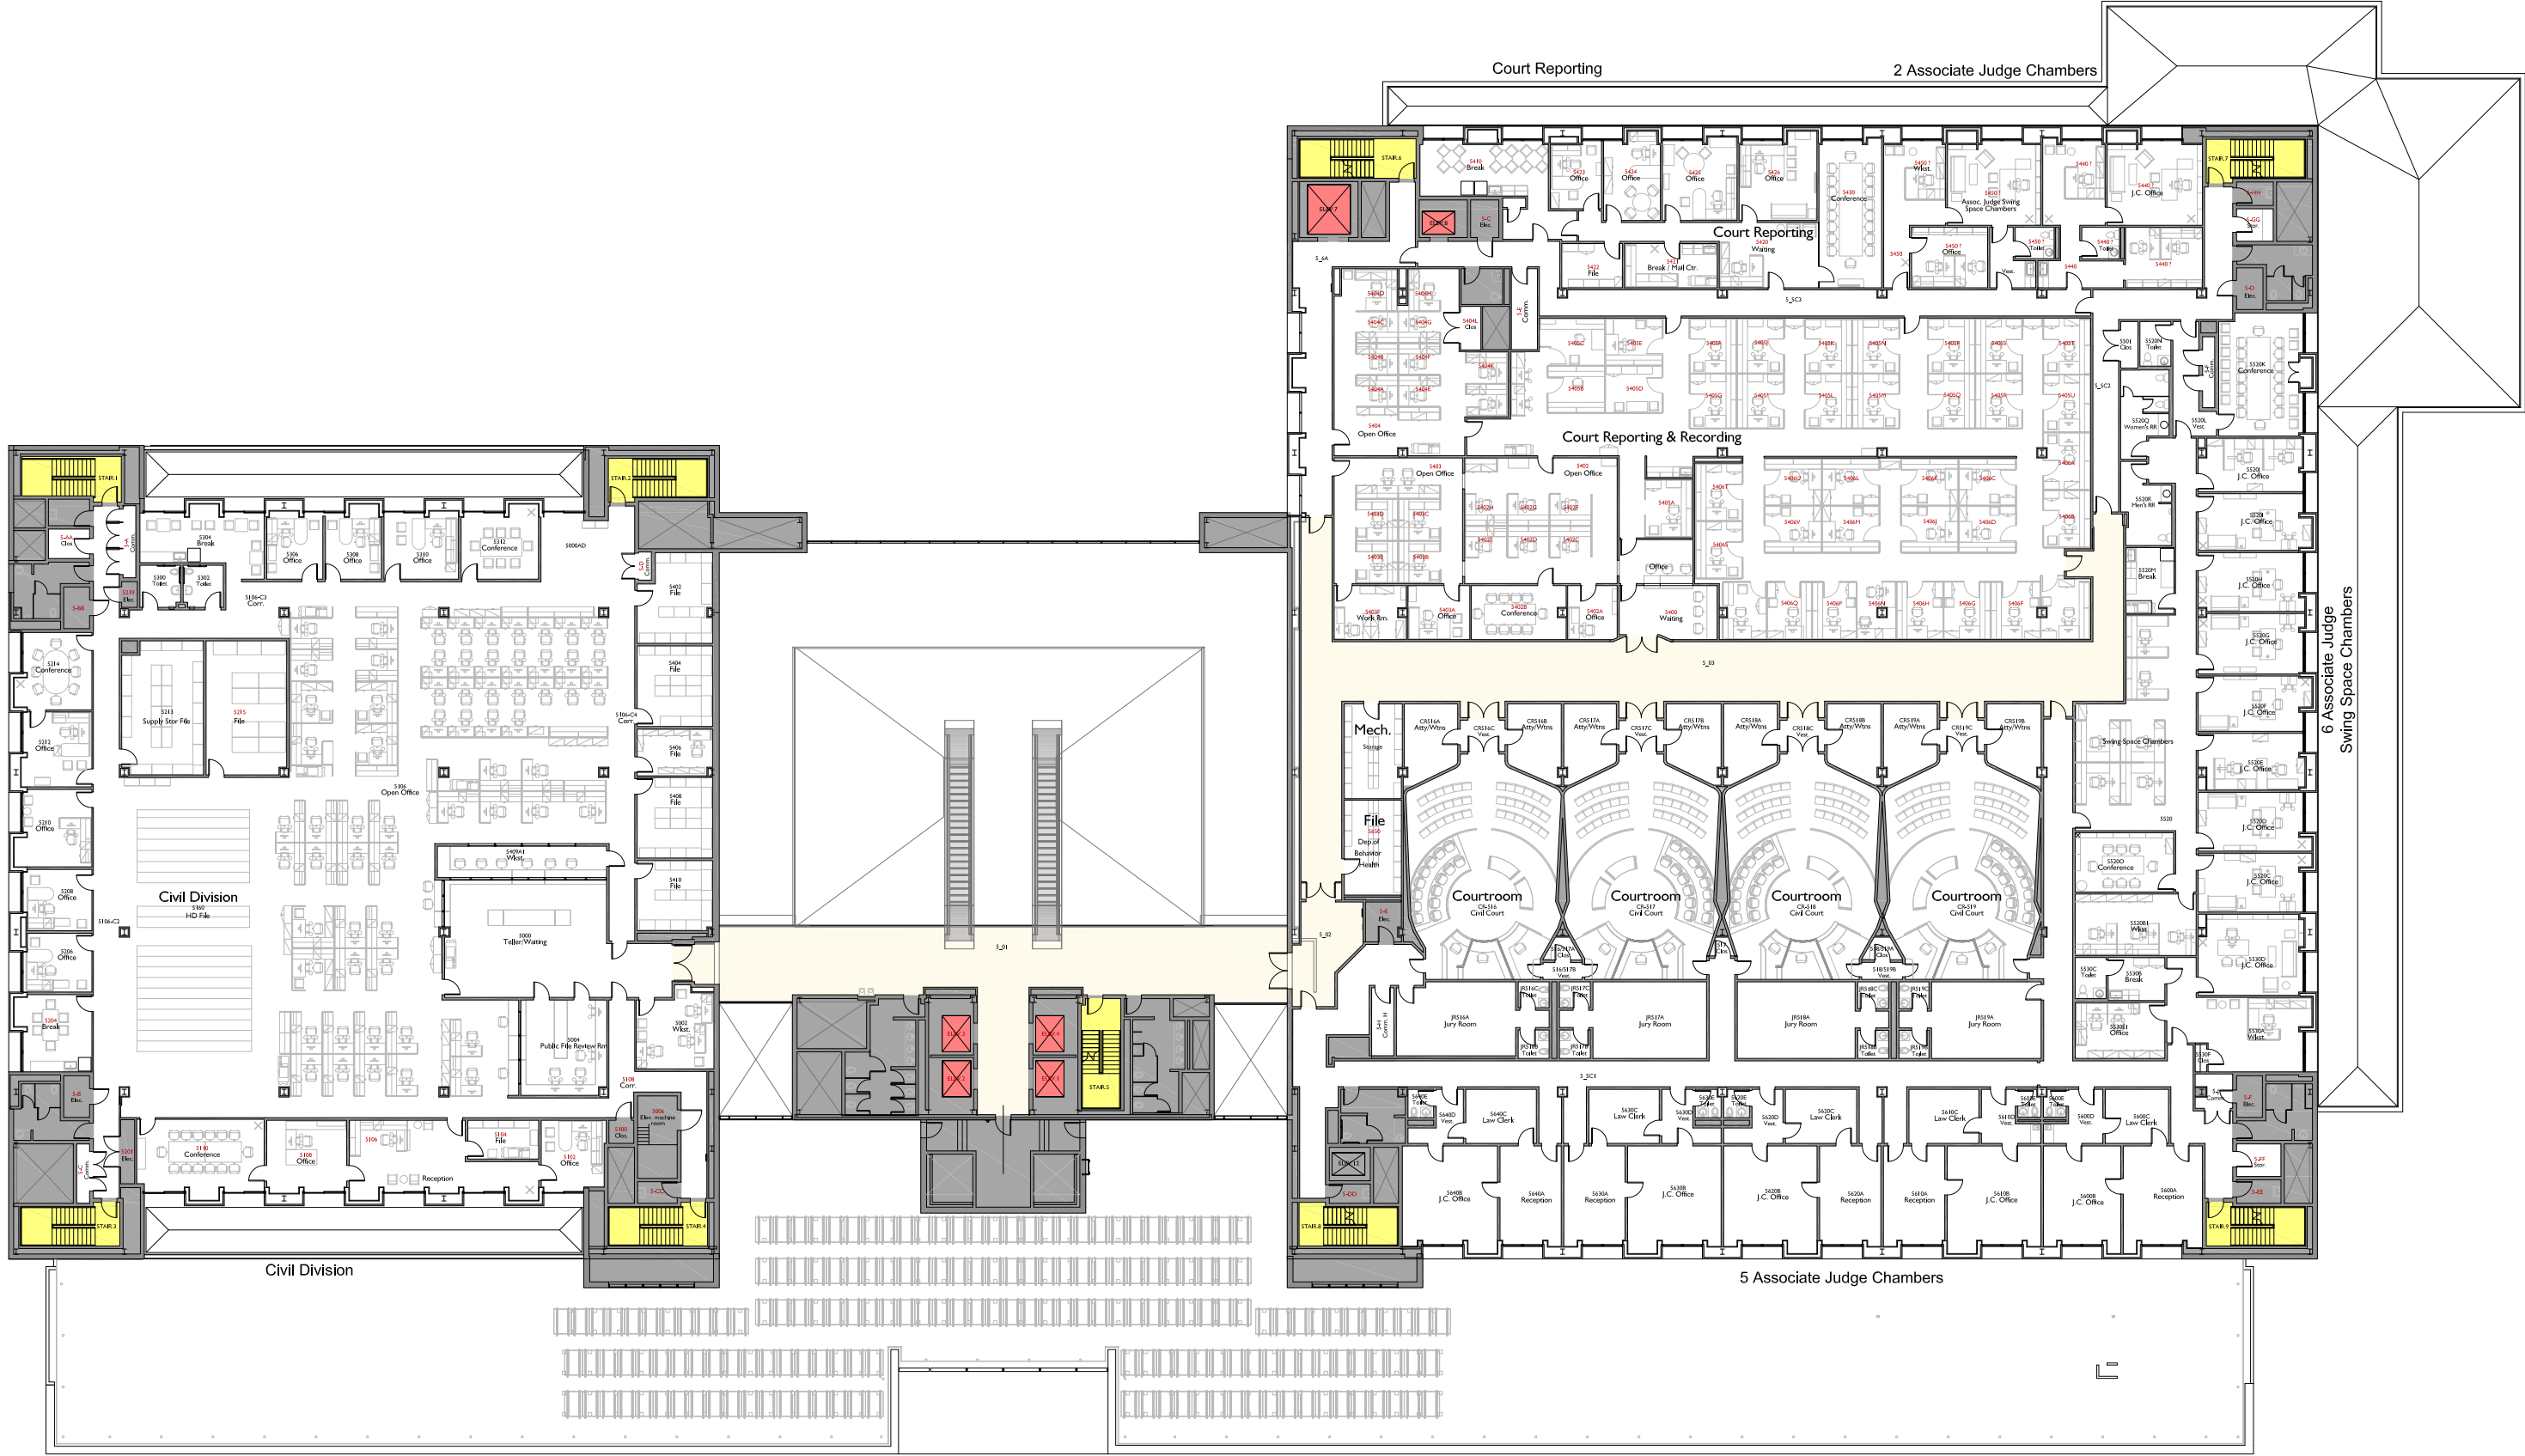

XX New room number as provided by DC Courts  
XX Unchanged Existing room number



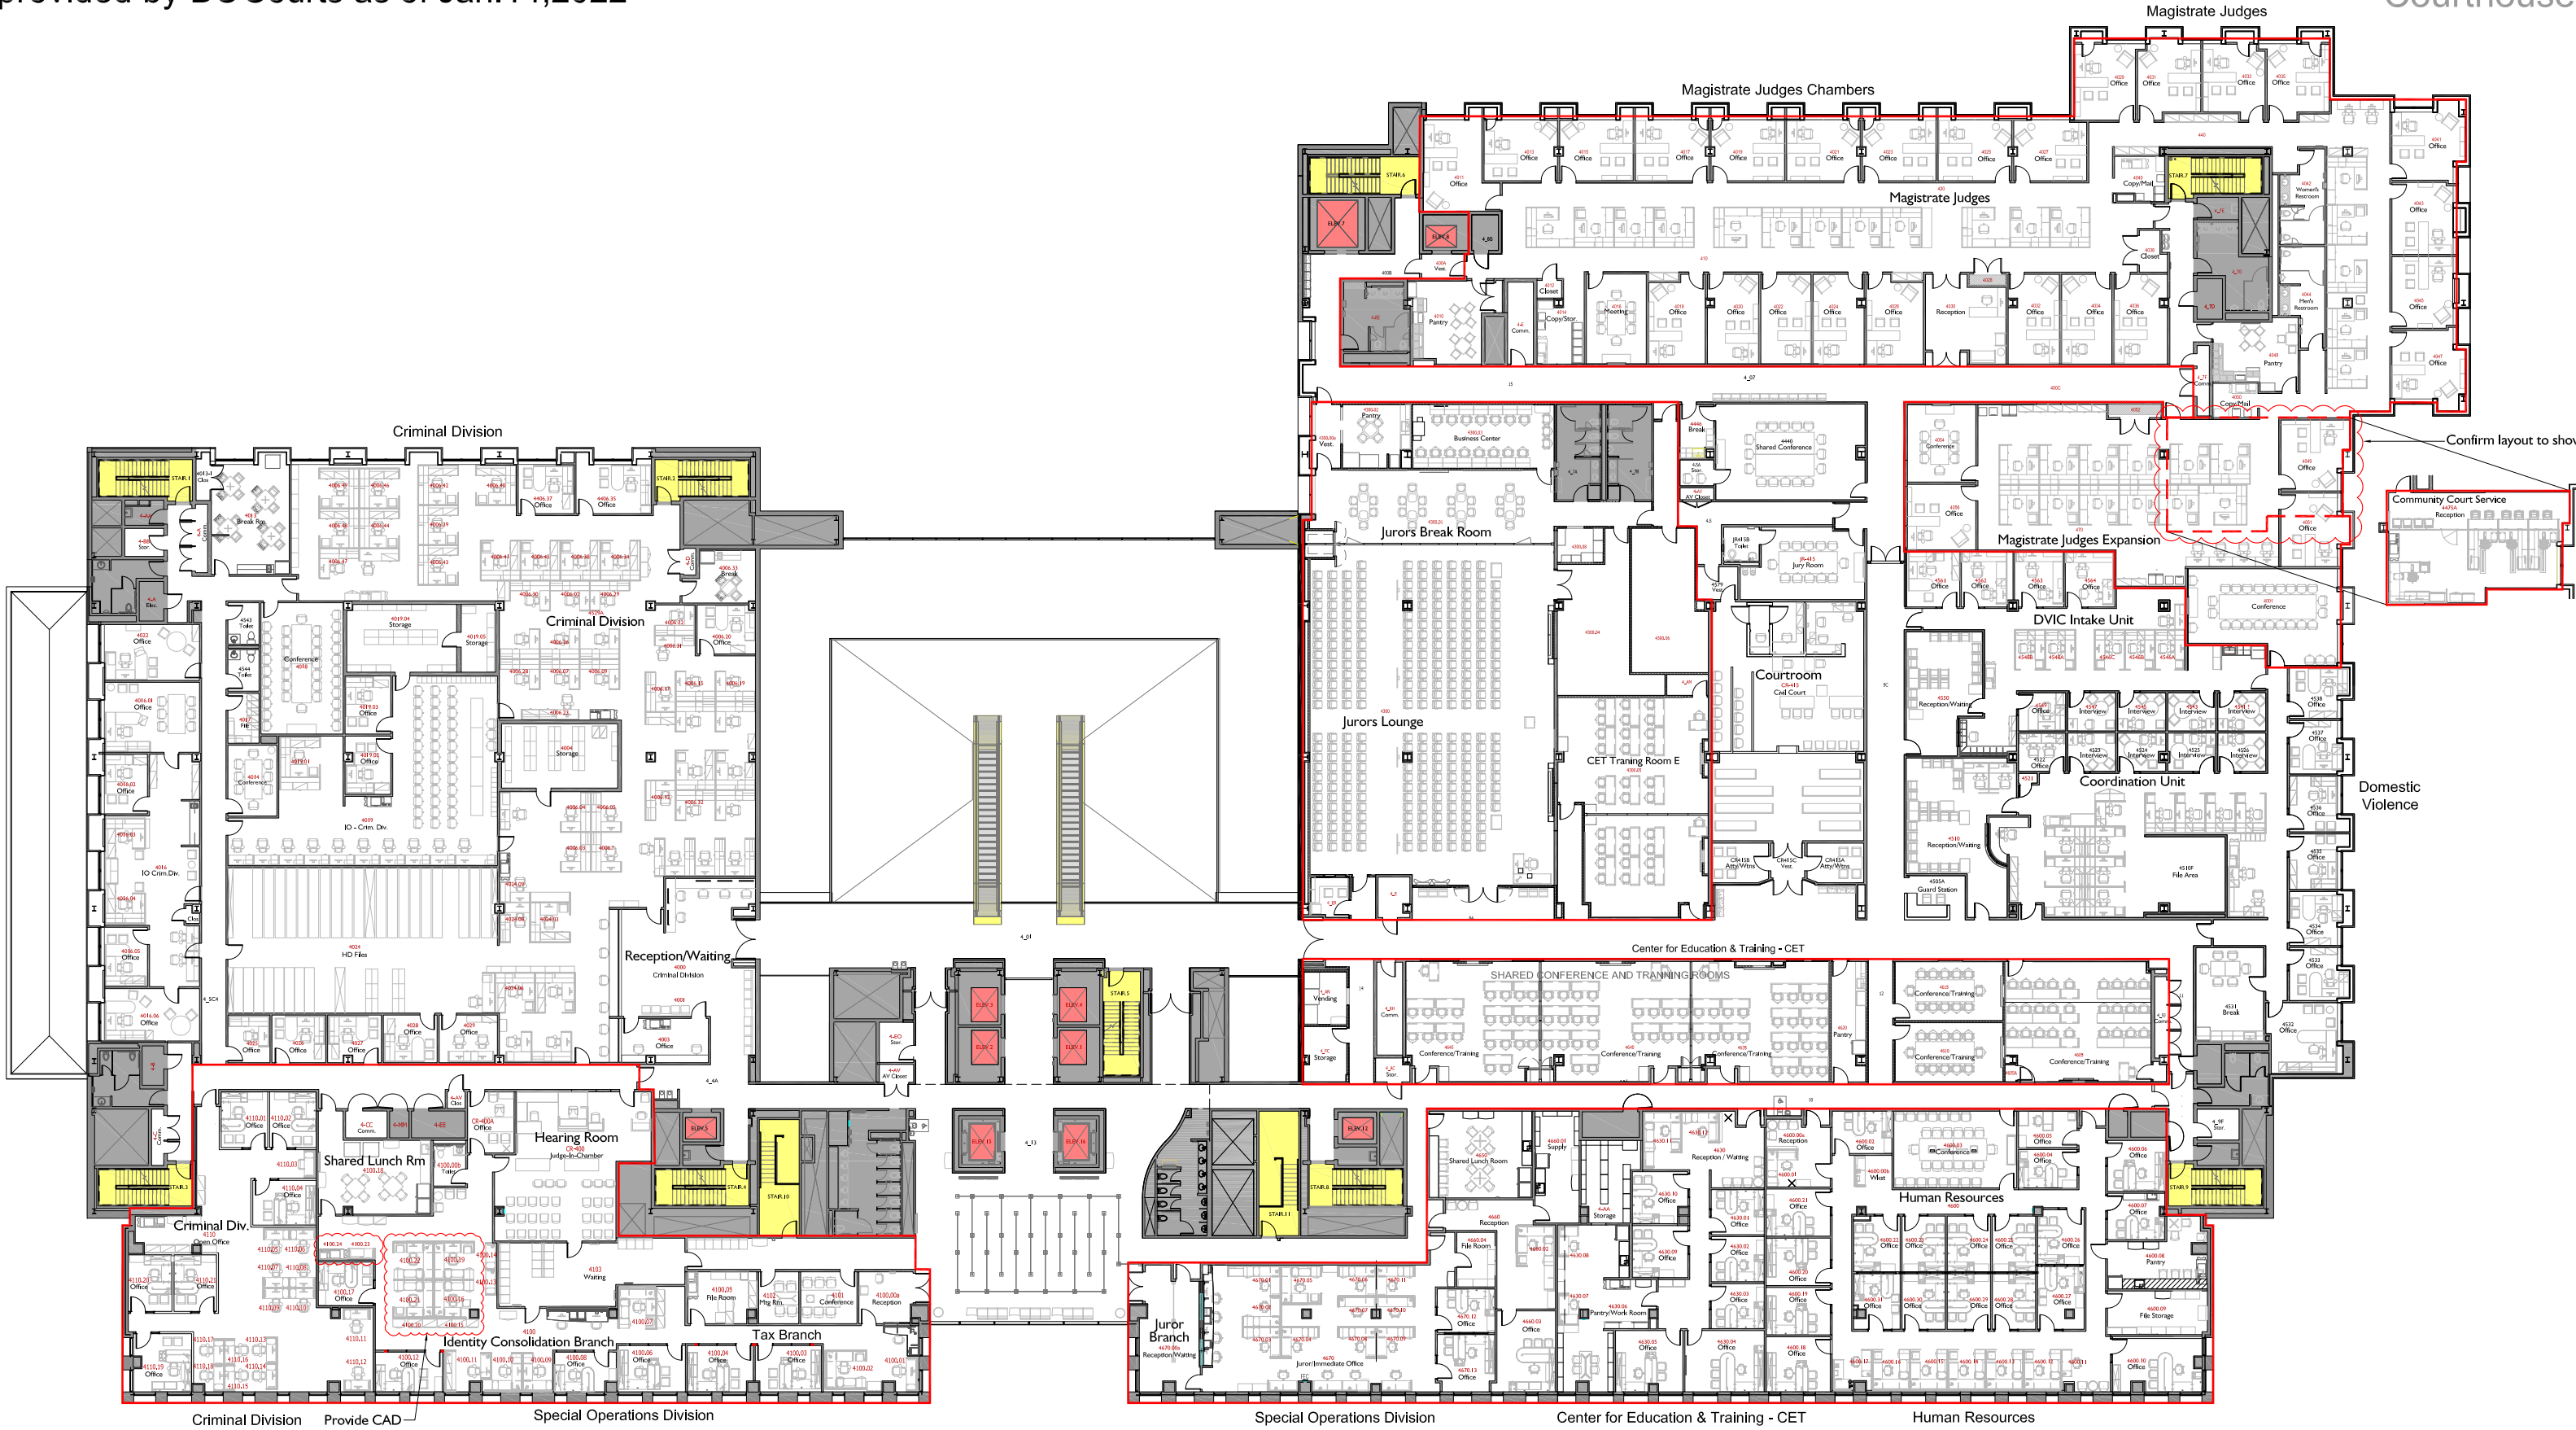

XX New room number as provided by DC Courts  
XX Unchanged Existing room number





# Moultrie Courthouse




### 3rd Floor



January, 2022



# Moultrie Courthouse

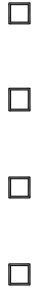

January, 2022

## 2nd Floor

# Moultrie Courthouse




January, 2022





Updated drawings based on mark-ups  
provided by DC Courts as of Jan.14,2022

Moultrie  
Courthouse

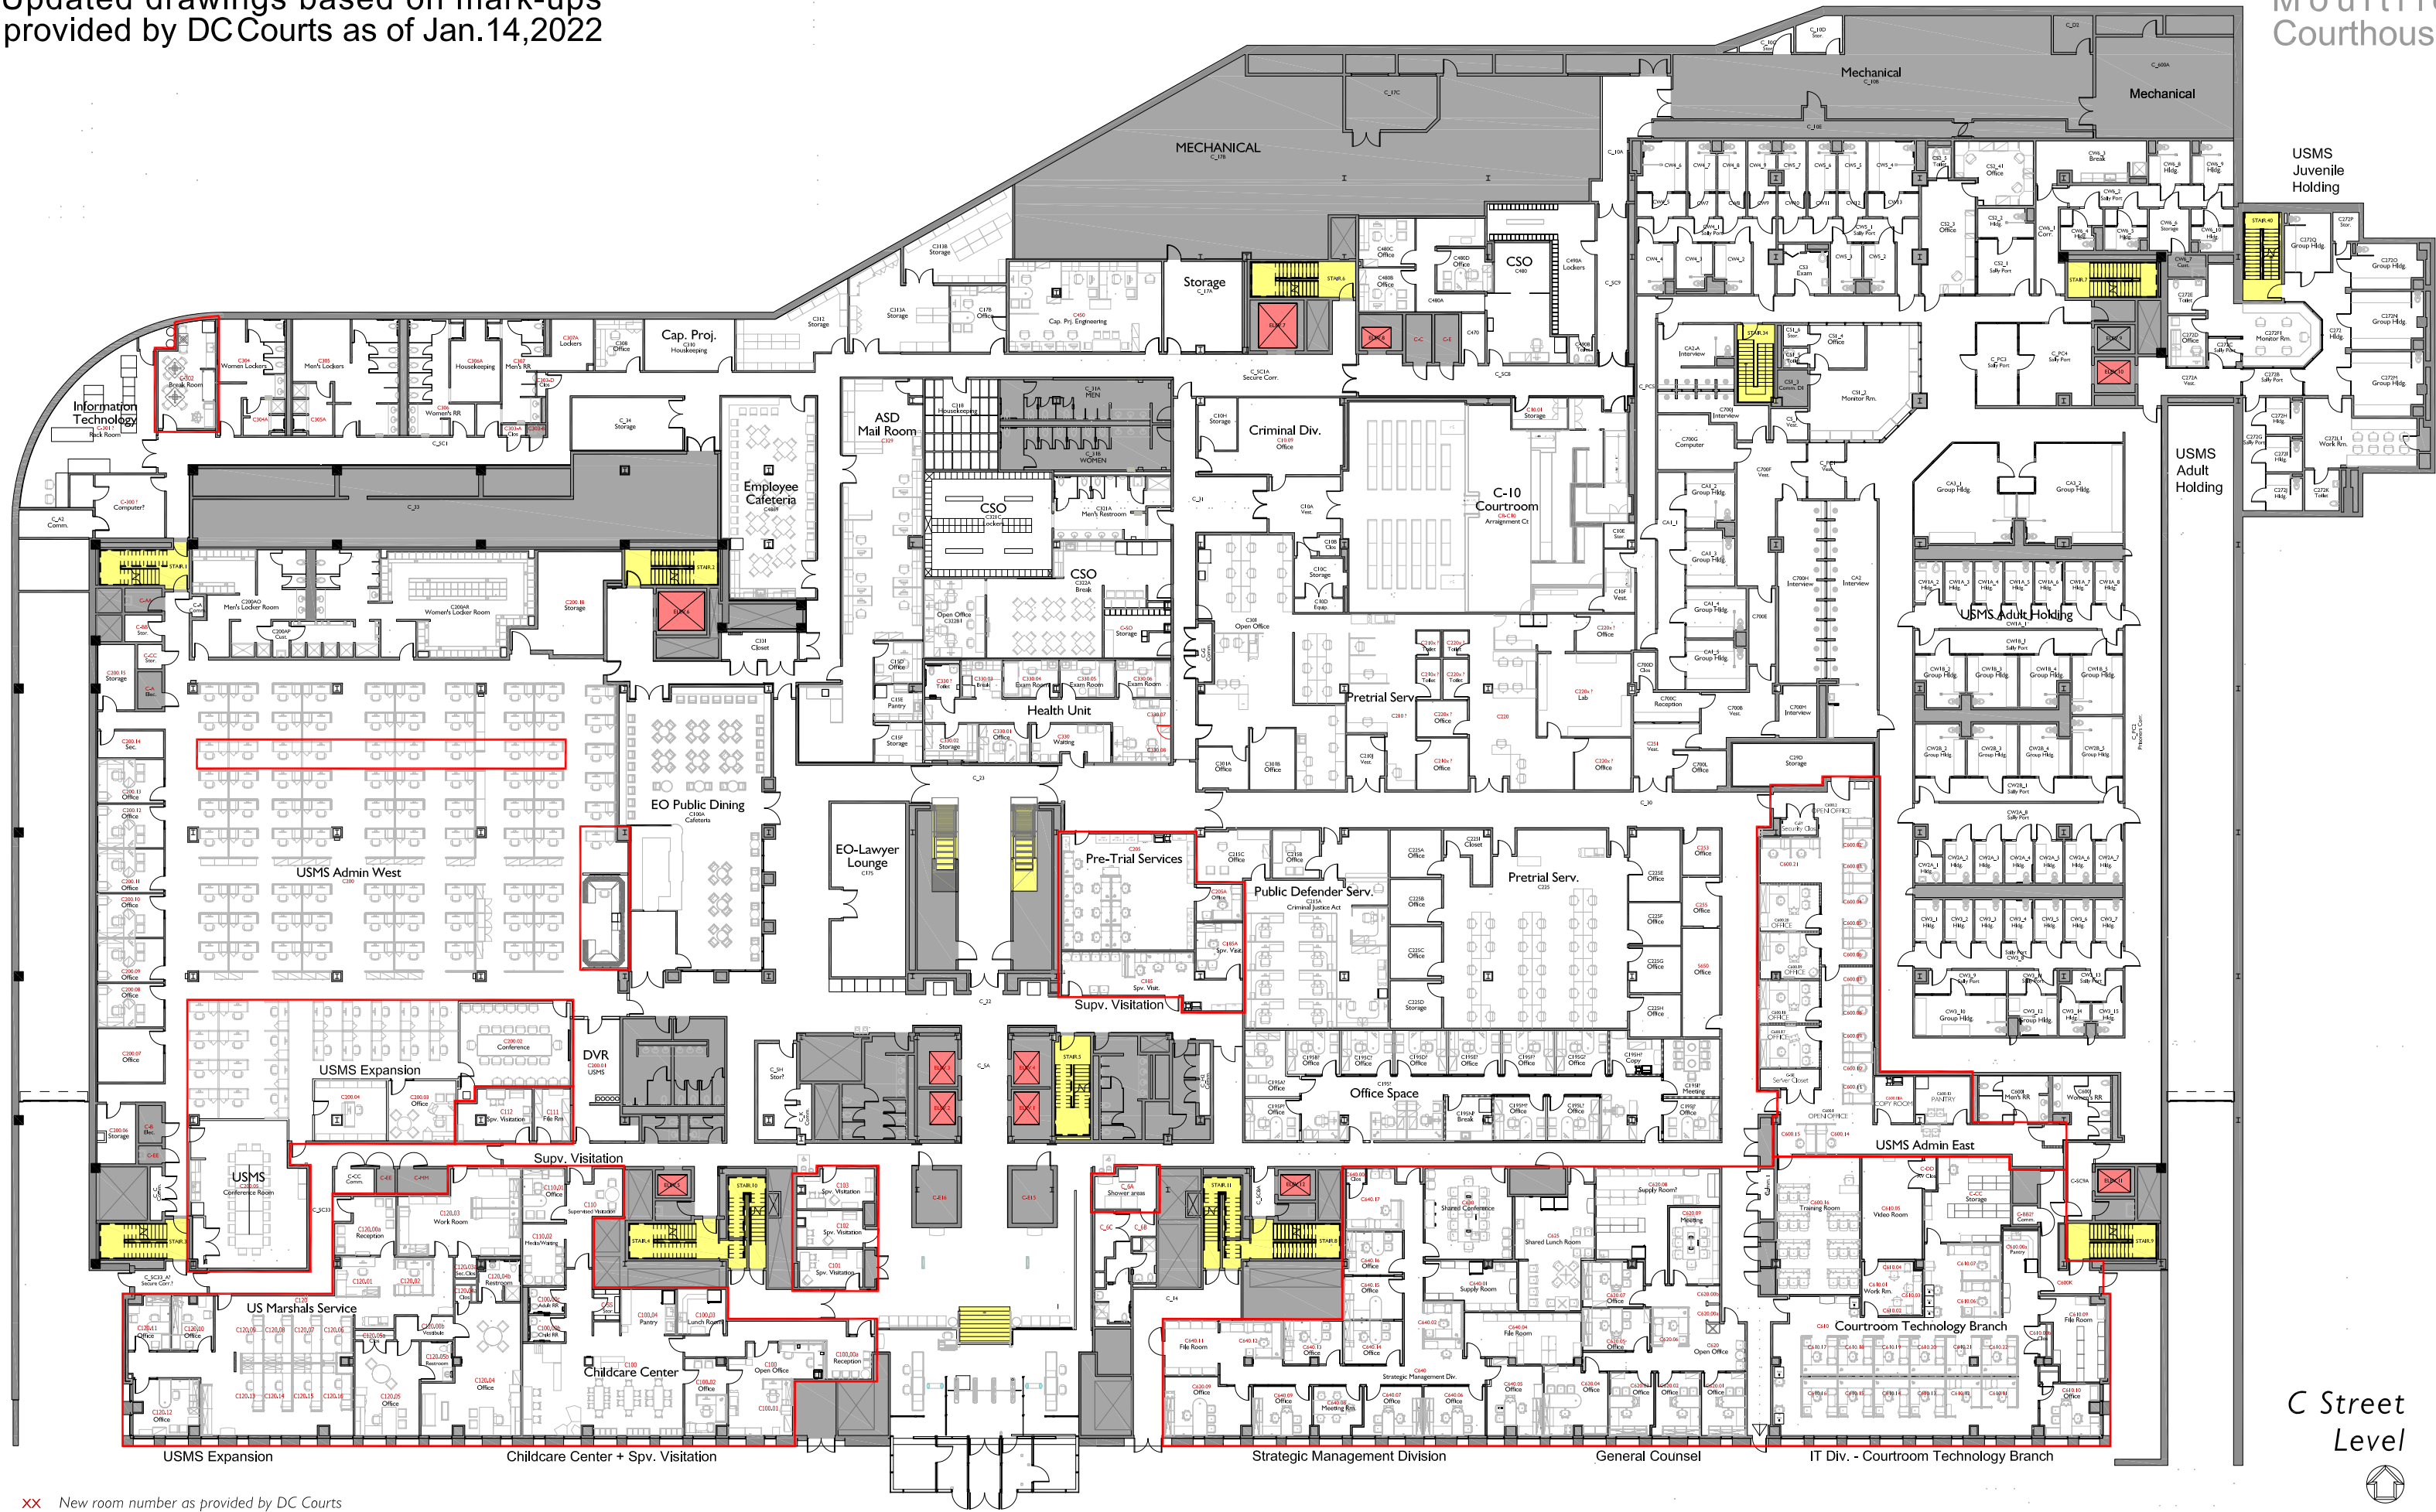

XX New room number as provided by DC Courts  
XX Unchanged Existing room number

Scale: 1/32" = 1'-0"

January, 2022